

SURVEY NO.	FINISHED PLANS	REVISIONS	LOCATION	DATE


REFERENCES 3
BP-063-1-503 7
S-53(1)

MIDPOINT OF PROJECT 3
Western Zone 8
State Plane Coordinates 7
 $X = 220,000$
 $Y = 610,000$


DESIGN DATA 3
7 1991 ADT = 19,000
2011 ADT = 30,000
Min Design Speed = 50 MPH

F.H.W.A. REGION	STATE	PROJECT NO.	SHEET NO.	TOTAL SHEETS	AS BUILT
9	ARIZ.	B-063-1-610	2	79	
095 YU 020					

LENGTH OF PROJECT 3
7 Sta 1079+00.00 to 1089+59.40 Bk = 1,059.40'
Sta 1089+58.35 Ahd to 1124+00.00 = 3,441.65'
Gross & Net Length = 4,501.05' - 0.85 Mile
Mile Post 19.70 to 20.55

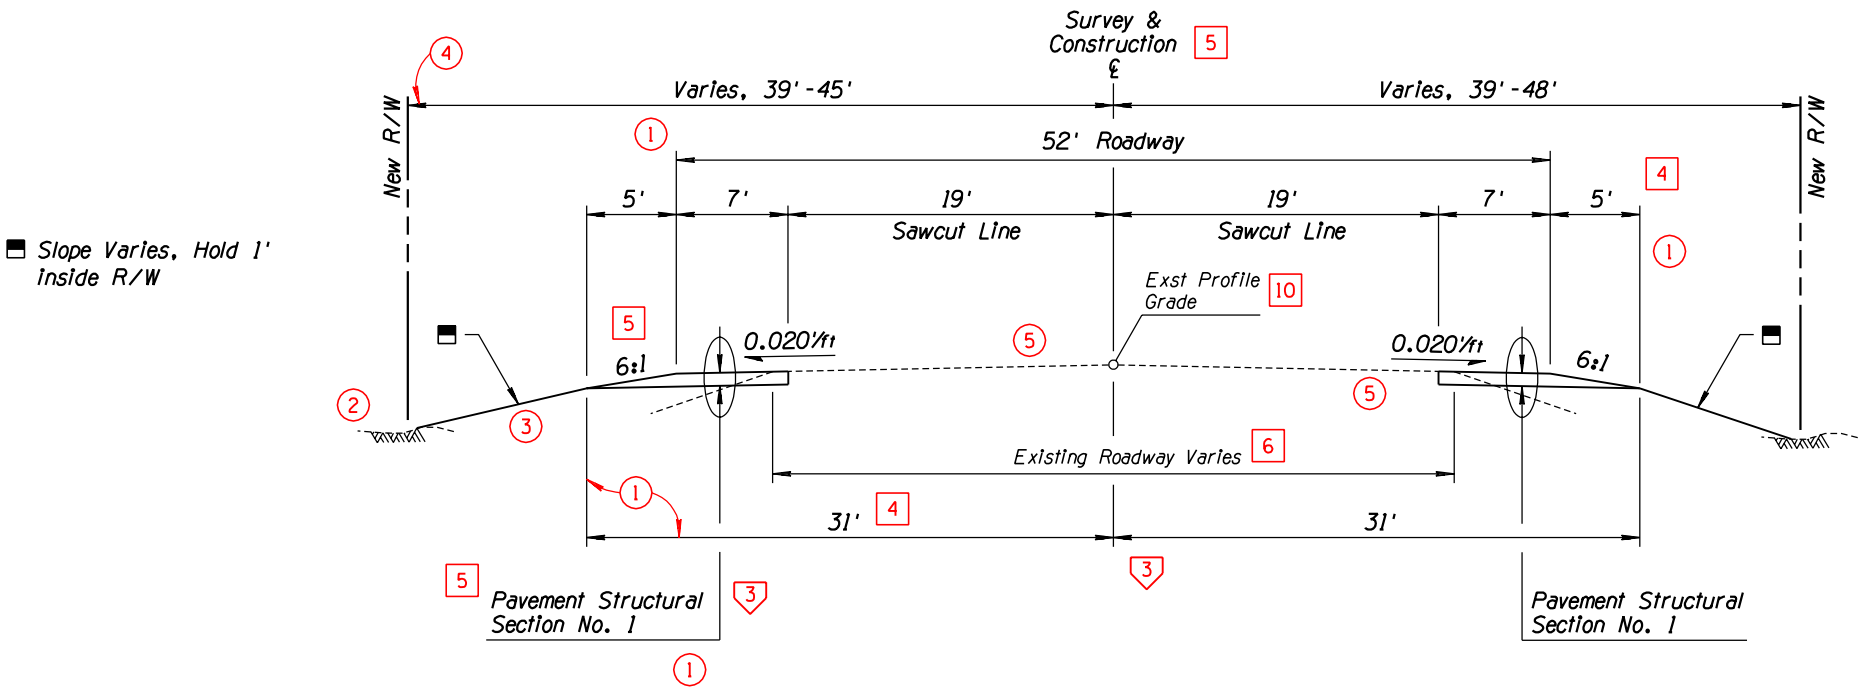

Sheet No.	Sheet Type
1	Face Sheet
1A-1B	ADOT Standard Drawings
2-3	Design Sheets
4-5	Pipe Summary Sheet
6	PSWP Summary Sheet
7-21	Detail Sheets
22-37	Plan & Profile Sheets
38-56	Storm Drain Plan & Profile Sheets
57-59	PSWP Profile Sheets
60-66	Driveway Profile Sheets
67-79	Traffic Sheets

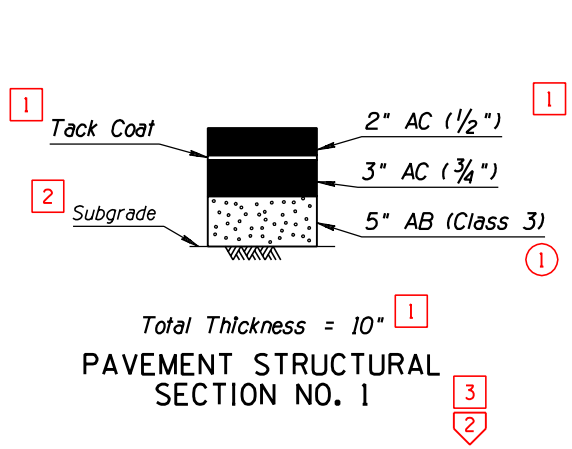

TYPICAL SECTION 3
Sta 1079+00 to 1086+00 5

- GENERAL NOTES 3
- 9 The roadway plans have been utilizing the 1989 Construction Standard Drawings (C-Series), and current revisions.
- The project roadway shall be striped by contractor forces in accordance with the current edition of the Signing and Marking Standard Drawings (M&S-Series) and striping plans.
- R/W Markers shall be furnished and placed by the contractor, as directed by the Engineer. Std C-21.10.
- For R/W information not shown, see Right-of-Way project No. BP-063-1-611.
- Bench markers will be furnished by the State and shall be placed by the Contractor. Std C-21.20.
- Existing utility locations are approximate. The contractor shall verify the exact location and depth of all underground facilities.
- 4 For Superelevation information not shown, see Drawing Series D-56 in the Roadway Design Guides for use in Office and Field - 1986.

DESIGN	NAME	DATE	ARIZONA DEPARTMENT OF TRANSPORTATION HIGHWAYS DIVISION HIGHWAY PLANS SERVICES
DRAWN	T. MACBETH	10-90	
CHECKED	M. HAUER	10-90	
TEAM LEADER	R. DELANO	12-90	
			DESIGN SHEET
ROUTE	LOCATION		
US 95	32nd ST - 26th ST (YUMA)		
			SHEET 1 OF 2

ccccDGNeSPECIFICATIONcccc

VIEW NAME:

ccccSYSTIMEcccc

TRACS NO. H0000 01 C OF